
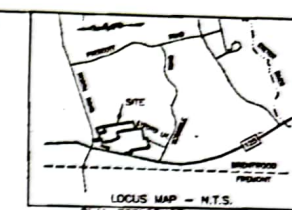


Command= 210-							
Point#, Start#-End# or G#= 1-100							
Bearing	Distance	Elev	Descrip	Pnt.	Northing	Easting	Type
-----01-05-2024-----12:51:26-----D:...\BMHOME2							
				1	5000.0000	5000.0000	
				2	5164.2962	4885.9529	TRA
				3	5182.3022	4965.2954	TRA
				4	5260.9283	5149.1919	TRA
				5	5339.5545	5333.0884	TRA
				6	5375.4827	5417.1199	TRA
				7	5149.2870	5404.5755	TRA
				8	5138.4723	5375.2671	TRA
				9	5069.2361	5187.6336	TRA
				10	5000.0000	5000.0000	TRA
				11	5149.2870	5404.5755	TRA
				12	5149.2870	5404.5755	TRA
				16	4976.8260	5016.0864	TRA
				17	4606.1728	4482.1236	RP
				18	4822.1995	5095.1754	PT
				19	4929.1792	5385.8117	TRA
				20	4941.7922	5387.0125	TRA
				21	5139.1100	5411.0779	TRA
			SETHUB	50	5103.6252	5235.7225	
			SET0	51	5025.3665	5013.5740	TRA
			FNDDHSB	52	5000.0000	5000.0000	SS
			FNDDHSB	53	4990.9858	4945.3582	SS
			CORHSE	54	5102.2893	5167.1797	SS
				55	5154.7852	5137.4799	TRA
			APPIPIN	56	5069.0847	5187.6558	SS
			CORCHIM	57	5106.7124	5178.1352	SS
			CORHSE	58	5116.9972	5191.3016	SS
			CORDECK	59	5124.7475	5202.9495	SS
			CORDECK	60	5136.6266	5195.7309	SS
			CORCHIM	61	5161.0600	5166.6524	SS
			CORCGAR	62	5168.4488	5159.9072	SS
			PINJB	63	5260.8796	5149.2533	SS
			PINJB	64	5138.4891	5375.3147	SS
				65	5378.8592	5425.0172	INT
				66	5298.1566	4793.0329	TRA
				67	5412.2037	4957.3292	RP
				68	5334.2201	4773.1593	PT
				69	5595.6410	5429.3309	TRA

Point#, Start#-End# or G#= 4-

MAY 27 11:34 AM '98

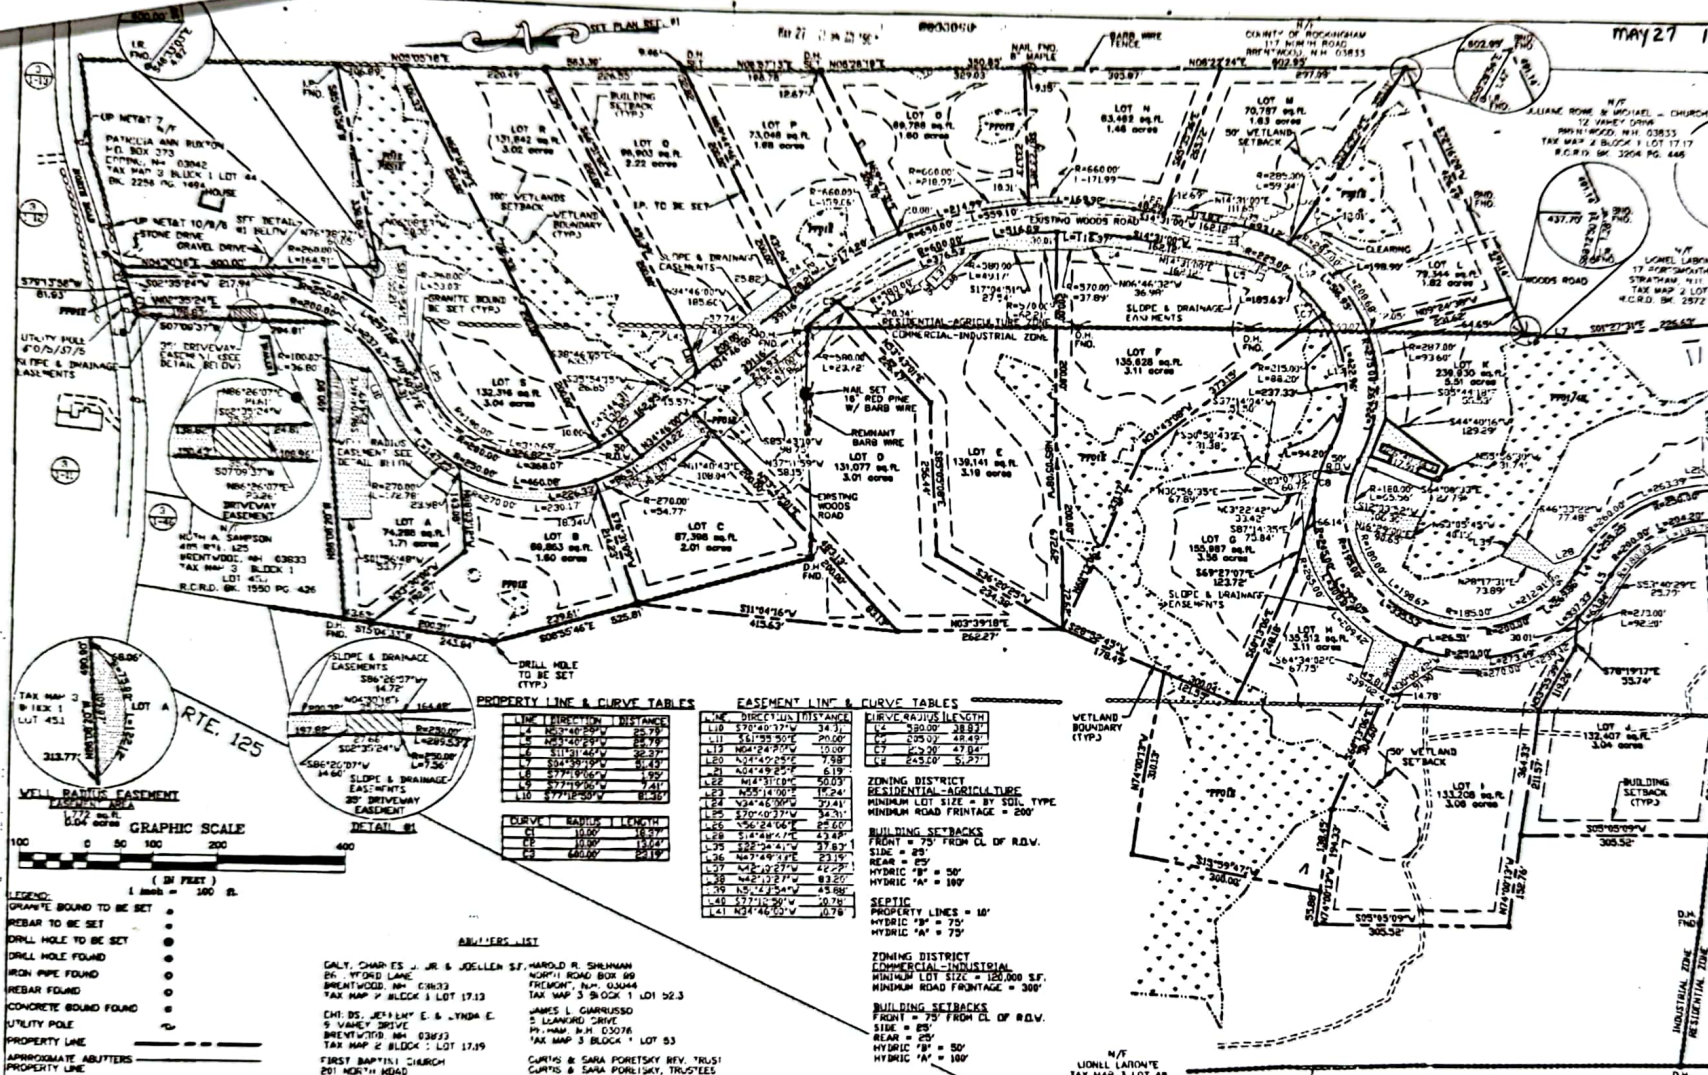

- PLAN REFERENCE**
1. "BLACKTHORN AT BRENTWOOD" BY JAMES M. LAMBLE, ASSOC. DATED AUGUST 1, 1994 AND RECORDED R.C.D. #0-24741, SHEET 5 OF 8.
  2. "PLAN OF LAND OF RUTH SAMMONS, BRENTWOOD, N.H." BY RONALD B. WOODS, DATED OCTOBER 28, 1988 AND RECORDED AT THE R.C.D. PLAN #0-18883.
  3. "PLAN OF LAND IN BRENTWOOD, N.H. OWNED BY RUTH A. SAMMONS" BY JAMES M. LAMBLE, DATED JULY 1972, AND RECORDED R.C.D. PLAN #0-3440.
  4. "SUBDIVISION OF LAND FOR KENNETH LUTES IN BRENTWOOD, N.H. FREEMONT, N.H. BY PARKER SURVEY ASSOC., INC. DATED FEB. 1973 AND RECORDED PLAN #0-5106.

- NOTES**
1. A WAIVER OF SUBDIVISION REGULATION SECTION 6.4 HAS BEEN GRANTED. THIS RELATES TO THE CURVE BASIS AT THE INTERSECTION OF R.D. OF LYONS LANE AND NORTH ROAD.
  2. IRON PINS TO BE SET EVERY 200' ON LOT LINES LONGER THAN 400'.
  3. VARIOUS STATE SUBDIVISION APPROVAL SECTION 4.2 HAS BEEN GRANTED. THIS RELATES TO THE SLIGHT INCREASE IN ESTIMATED RESEARCH DUE TO THE SUBDIVISION DEVELOPMENT TO TAX MAP 3 LOT 4. LAND TO BE CONVEYED FOR RESIDENTIAL USE ONLY.
  4. ALL PROPOSED LOTS TO BE CONVEYED FOR RESIDENTIAL USE ONLY.
  5. HARBOR DRIVE PERMIT # 26-22-106.
  6. A WAIVER OF SUBDIVISION REGULATION SECTION 4.2 HAS BEEN GRANTED. THIS RELATES TO THE SLIGHT INCREASE IN ESTIMATED RESEARCH DUE TO THE SUBDIVISION DEVELOPMENT TO TAX MAP 3 LOT 4. LAND TO BE CONVEYED FOR RESIDENTIAL USE ONLY.
  7. ALL PROPOSED LOTS TO BE CONVEYED FOR RESIDENTIAL USE ONLY.

"THIS SUBDIVISION PLAN IS APPROVED UNDER THE TERMS AND CONDITIONS OF THE AGREEMENT IN CONNECTION WITH APPROVAL OF SUBDIVISION PLAN BETWEEN THE SUBDIVIDER AND THE TOWN OF BRENTWOOD PLANNING BOARD DATED MAY 21, 1998, TO BE RECORDED AT THE ROCKINGHAM COUNTY REGISTRY OF DEEDS HEREWITH."

**OWNER OF RECORD**  
LYONS LANE  
PORTSMOUTH AVENUE  
STRAITHAM, N.H. 03885  
TAX MAP 3 BLOCK 1 LOT 4  
LOTS 45, 48  
LOT AREA  
3,367.188 sq. ft.  
77.30 acres

**PROPERTY LINE & CURVE TABLES**

LINE	BEARING	DISTANCE
1	N 10° 10' 00" E	100.00
2	S 89° 50' 00" W	100.00
3	N 10° 10' 00" E	100.00
4	S 89° 50' 00" W	100.00
5	N 10° 10' 00" E	100.00
6	S 89° 50' 00" W	100.00
7	N 10° 10' 00" E	100.00
8	S 89° 50' 00" W	100.00
9	N 10° 10' 00" E	100.00
10	S 89° 50' 00" W	100.00

**EASEMENT LINE & CURVE TABLES**

LINE	BEARING	DISTANCE
1	N 10° 10' 00" E	100.00
2	S 89° 50' 00" W	100.00
3	N 10° 10' 00" E	100.00
4	S 89° 50' 00" W	100.00
5	N 10° 10' 00" E	100.00
6	S 89° 50' 00" W	100.00
7	N 10° 10' 00" E	100.00
8	S 89° 50' 00" W	100.00
9	N 10° 10' 00" E	100.00
10	S 89° 50' 00" W	100.00

**ZONING DISTRICT**  
RESIDENTIAL - AGRICULTURE  
MINIMUM LOT SIZE = 50,000 SQ. FT.  
MINIMUM ROAD FRONTAGE = 300'

- LEGEND**
- GRANITE BOUND TO BE SET
  - REBAR TO BE SET
  - DRILL HOLE TO BE SET
  - DRILL HOLE FOUND
  - IRON PIPE FOUND
  - REBAR FOUND
  - CONCRETE BOUND FOUND
  - UTILITY POLE
  - PROPERTY LINE
  - APPROXIMATE ADJUTERS
  - PROPERTY LINE
  - STONEWALL
  - BARS WIRE FENCE
  - WETLAND BOUNDARY
  - SLOPE & DRAINAGE
  - EASEMENT

- ADJUTERS LIST**
- GALT, CHARLES J. JR. & JOELLEN S.F. HAROLD R. SHEPHERD  
26 WYOMING LANE  
BRENTWOOD, NH 03833  
TAX MAP 3 BLOCK 1 LOT 17.13
  - CHI, BO, JESSIE E. & JONIA E.  
9 WARE DRIVE  
BRENTWOOD, NH 03833  
TAX MAP 3 BLOCK 1 LOT 17.19
  - FIRST BAPTIST CHURCH  
201 NORTH ROAD  
BRENTWOOD, NH 03833  
TAX MAP 3 BLOCK 1 LOT 11
  - JOSEPH H. & DEBRA J. O'DONNELL  
119 NORTH ROAD  
BRENTWOOD, NH 03833  
TAX MAP 3 BLOCK 1 LOT 12
  - SAMMONS REALTY TRUST  
133 PORTSMOUTH AVENUE  
BRENTWOOD, NH 03833  
TAX MAP 3 BLOCK 1 LOT 4
  - DAVID A. & RALPH KOWALSKI  
14 NICKER ROAD  
BRENTWOOD, NH 03833  
TAX MAP 3 BLOCK 1 LOT 46
  - DAVID L. ROBERTS & RAMELA DANIELS  
1333 PORTSMOUTH AVENUE  
BRENTWOOD, NH 03833  
TAX MAP 3 BLOCK 1 LOT 49.3

- ADJUTERS LIST**
- WYOMING LANE  
BRENTWOOD, NH 03833  
TAX MAP 3 BLOCK 1 LOT 17.13
  - WARE DRIVE  
BRENTWOOD, NH 03833  
TAX MAP 3 BLOCK 1 LOT 17.19
  - NORTH ROAD  
BRENTWOOD, NH 03833  
TAX MAP 3 BLOCK 1 LOT 11
  - NORTH ROAD  
BRENTWOOD, NH 03833  
TAX MAP 3 BLOCK 1 LOT 12
  - PORTSMOUTH AVENUE  
BRENTWOOD, NH 03833  
TAX MAP 3 BLOCK 1 LOT 4
  - NICKER ROAD  
BRENTWOOD, NH 03833  
TAX MAP 3 BLOCK 1 LOT 46
  - PORTSMOUTH AVENUE  
BRENTWOOD, NH 03833  
TAX MAP 3 BLOCK 1 LOT 49.3

**D-26292** Sheet 1 of 8

I CERTIFY THAT THIS PLAN IS THE RESULT OF A FIELD SURVEY, COMPLETED WITH A THEODOLITE AND ELECTRONIC DISTANCE METER, THAT WAS CONDUCTED UNDER MY DIRECT SUPERVISION. THE ACCURACY OF THE CLOSED POLYGON CALCULUS THE PRECISION OF 1:15,000.

JOHN BOUGLAS S. WOLLMAR, L.L.S. DATE: 10/21/97

NOTE: THE SUBDIVISION REGULATIONS OF THE TOWN OF BRENTWOOD ARE A PART OF THIS PLAN, AND APPROVAL OF THIS PLAN IS SUBJECT TO THE COMPLETION OF ALL REQUIREMENTS OF SAID SUBDIVISION REGULATIONS EXCEPTING ONLY INDICATORS MADE IN WRITING BY THE BOARD AND WRITTEN ON THE MYLAR.

NO.	DATE	REVISION	BY
1	3/2/98	ADDED EASEMENT, NOTE #7 AND REVISED NOTE #1	SW
2	3/4/98	REVISED EASEMENTS	SW
3	5/25/98	ADDED WETLAND CLASSIFICATIONS	SW
4	5/25/98	ADDED DRAINAGE EASEMENTS TO LOT G	SW
5	3/28/98	LOT E, LABELS	SW
6	1/28/97	REVISED PER TOWN COMMENTS	SW
7	10/21/97	ISSUED FOR APPROVAL	SW

**J/B**


**NORTH ROAD**  
BRENTWOOD, NEW HAMPSHIRE

**BOUNDARY SURVEY PLAN**  
FOR  
**PHASE II, BLACKTHORN SUBDIVISION**

**JONES & BEACH ENGINEERS, INC.**  
85 PORTSMOUTH AVENUE  
STRAITHAM, N.H. 03885  
PHONE 772-4246 FAX 772-0227

**SCALE:** 1" = 100'  
**DATE:** 10/21/97  
**FILE:** #07828  
**REV:** 8  
**SHEET NO.:** 1 OF 8



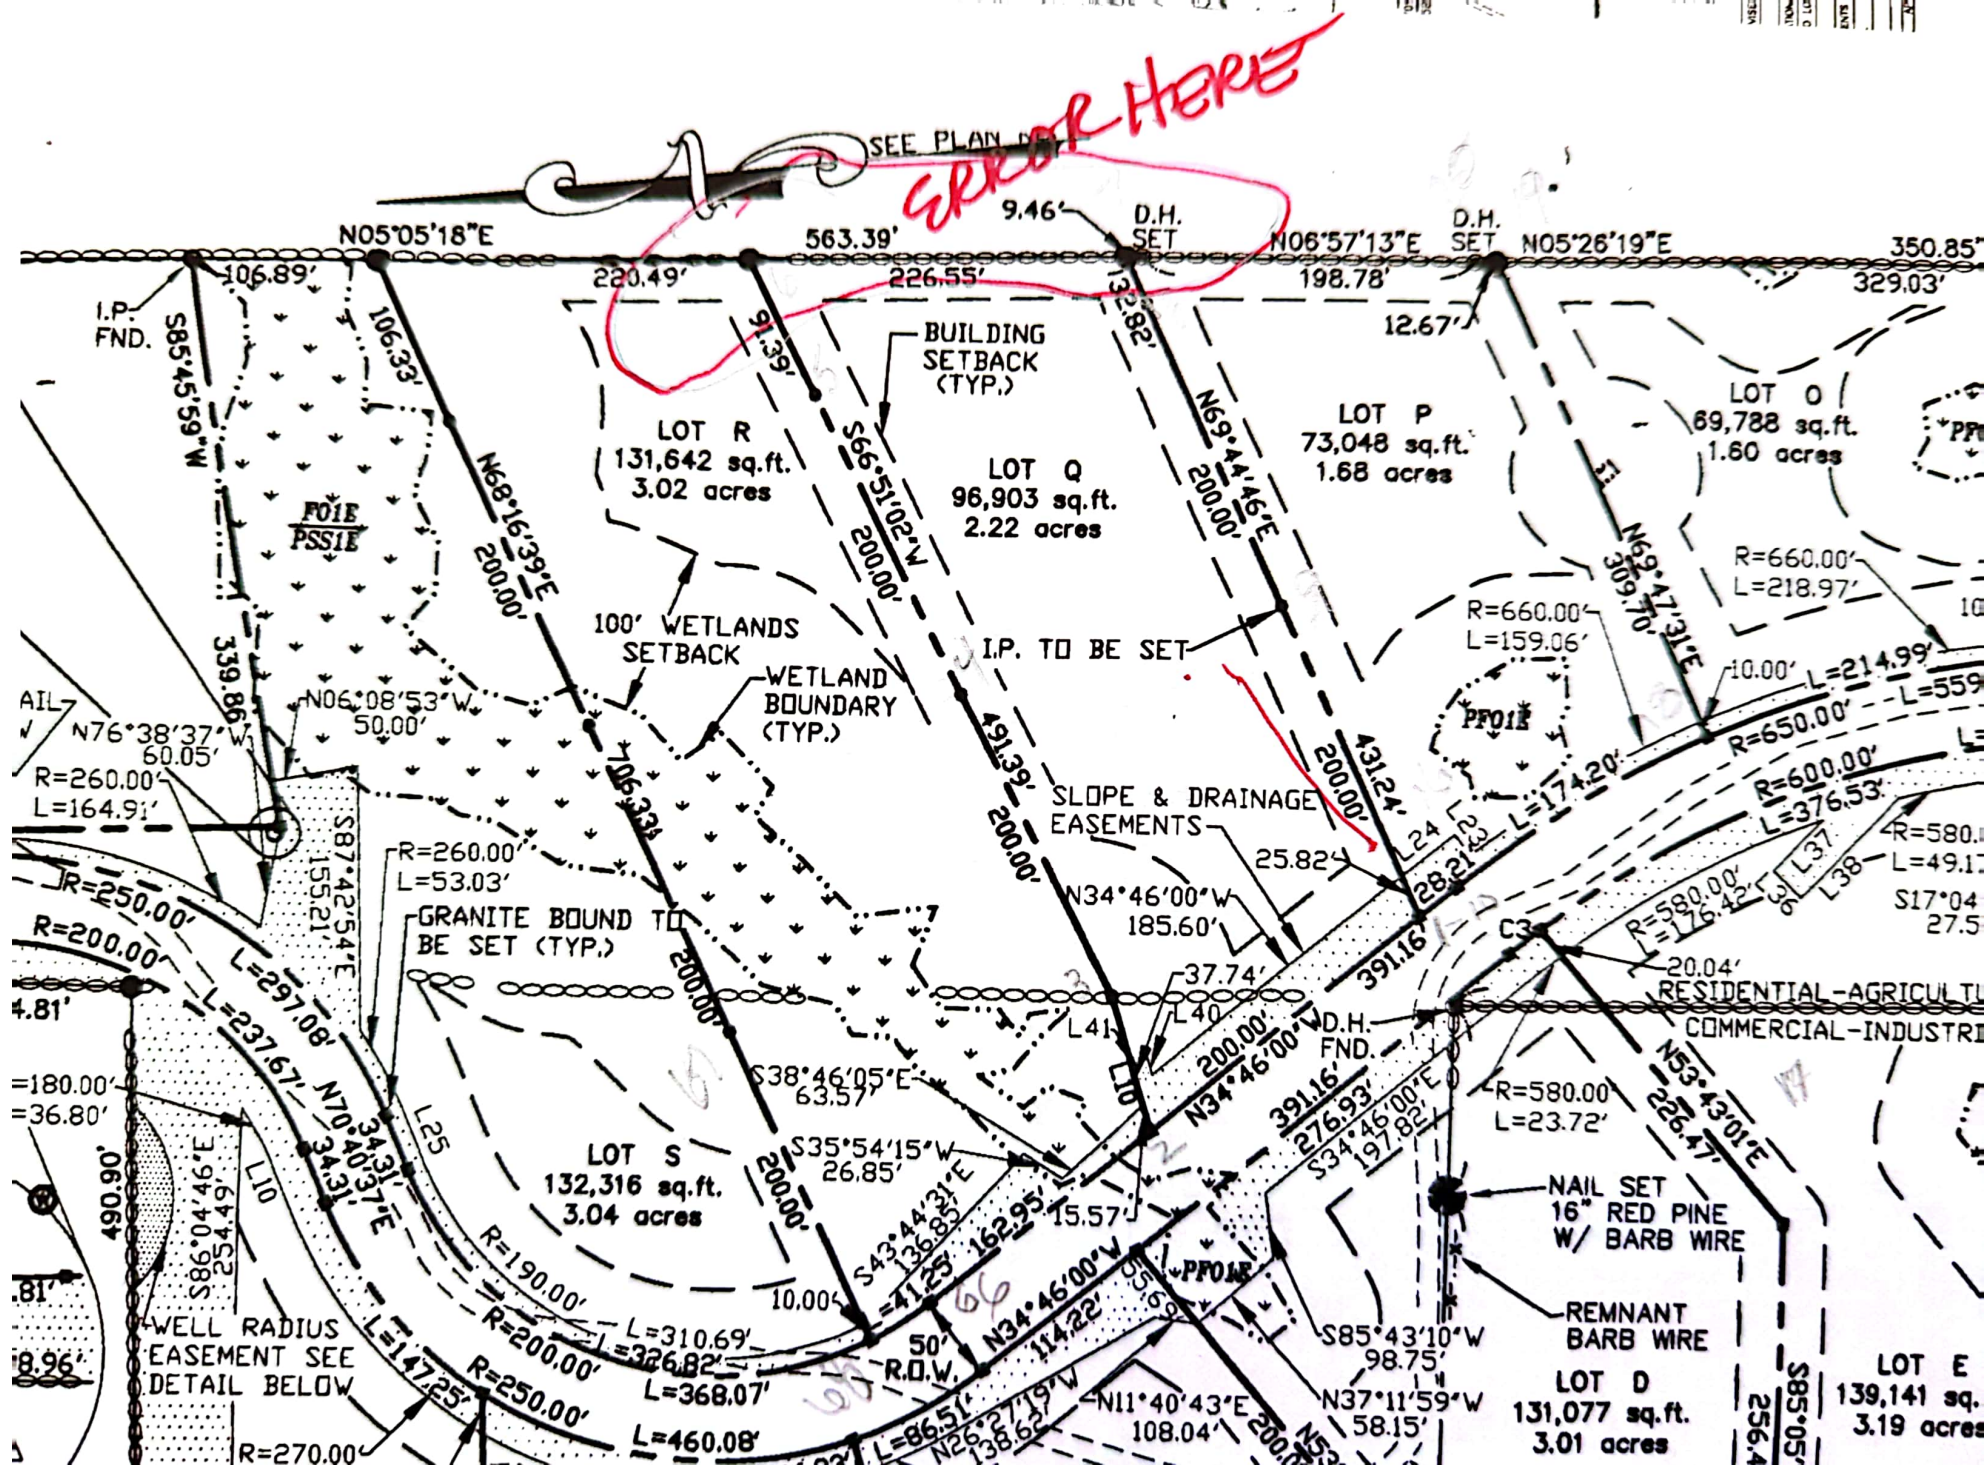



## WARRANTY DEED

KNOW ALL MEN BY THESE PRESENTS, That, Brian R. Golden, manager of B.R. Golden Builders, L.L.C., a New Hampshire limited liability company, of 88 Bald Hill Road, Newfields, County of Rockingham and State of New Hampshire;

FOR CONSIDERATION PAID,

GRANT TO: Marjorie P. Fowler and Gregg A. Fowler, husband and wife, of 31 Farm Lane, Seabrook, County of Rockingham and State of New Hampshire, as joint tenants with rights of survivorship;

with Warranty Covenants the following described property:

The parcel of land, with buildings thereon, situated in Brentwood, Rockingham County, State of New Hampshire, shown as "Lot Q" on the plan entitled, "BOUNDARY SURVEY PLAN FOR PHASE II, BLACKTHORN SUBDIVISION" prepared by Jones & Beach Engineers, Inc. dated October 21, 1997, with revisions through March 20, 1998, recorded at the Rockingham County Registry of Deeds as Plan D-26292 (the "Plan") bounded and described as follows:

Commencing at the point in the Easterly sideline of Lyford Lane, which point marks the Northwestern corner of the within described Lot Q and the Southwesterly corner of Lot R shown on said Plan, thence turning and running N 77° 12' 50" E along said Lot R a distance of 81.36 feet to a point; thence turning and running N 66° 51' 02" E along said Lot R a distance of 491.39 feet to a point at land now or formerly of the County of Rockingham; thence turning and running S 05° 05' 18" W along said land now or formerly of the County of Rockingham a distance of 226.55 feet to a point at Lot P shown on said Plan; thence turning and running S 69° 44' 46" W along said Lot P a distance of 432.82 feet to a point in the Easterly sideline of Lyford Lane; thence turning and running N 34° 46' 00" W along the Easterly sideline of Lyford lane a distance of 200.00 feet to the point of beginning.

Together with the right to pass and re-pass over the road shown on said Plan.

Subject to the Declaration of Protective Covenants for "Blackthorn at Brentwood, Brentwood, New Hampshire" dated July 8, 1996 recorded at the Rockingham County Registry of Deeds at Book 3184, Page 683 as amended by Amendment to Declaration of Protective Covenants dated June 8, 1998, recorded at the Rockingham County Registry of Deeds at Book 3299, Page 726. By acceptance of this deed, the grantee agrees to comply with said covenants.

Subject to the easement to Public Service Company of New Hampshire and New England Telephone and Telegraph Company dated September 6, 1996, recorded at the Rockingham County Registry of Deeds at Book 3180, Page 2274.

STATE OF NEW HAMPSHIRE			
DEPARTMENT OF REVENUE ADMINISTRATION		REAL ESTATE TRANSFER TAX	
3 THOUSAND 8 HUNDRED AND 78 DOLLARS			
MO.	DAY	YR.	AMOUNT
12	21	99	\$3878.00
416545			
VOID IF ALTERED			

0087131

Dec 21 10 50 AM '99

ROCKINGHAM COUNTY  
REGISTRY OF DEEDS



# TEST PIT DATA

TPH 2-23 DATE: 8-23-99  
 0-4" ORGANIC MAT  
 4-30" YELLOWISH BROWN SANDY LOAM  
 GRANULAR, FRABLE 10% S/L  
 30"-65" OLIVE YELLOW SANDY LOAM  
 GRANULAR, FRABLE 2.5% S/L  
 SHUT=30" LEDGE=65" WATER=N/O  
 ROOTS=36" PERC RATE=10 MIN/INCH @ 3"

TPH 2-24 DATE: 8-23-99  
 0-6" ORGANIC MAT  
 6-30" YELLOWISH BROWN SANDY LOAM  
 GRANULAR, FRABLE 10% S/L  
 30"-60" OLIVE YELLOW SANDY LOAM  
 MASSIVE, FIRM 2.5% S/L  
 SHUT=30" LEDGE=60" WATER=N/O  
 ROOTS=36" PERC RATE=10 MIN/INCH @ 3"

## DESIGN CRITERIA

BUILDING USE: RESIDENTIAL  
 NUMBER OF BEDROOMS: 4  
 DESIGN PERC RATE: 10 MIN/INCH  
 LEACHING AREA REQUIRED: 1100 SF  
 ALLOWED LEACHING AREA REDUCTION: 1100  
 (FILL OR GEOTEXTILE) 1,660  
 660 + 3 = 663 220 FEET OF GEOTEXTILE PIPING  
 REQUIRED, PROVIDE (2) GEOTEXTILE PIPES 37  
 FEET LONG, 6X37=222 FEET  
 BED WIDTH=6'-1" S, 5'1" S  
 7.5' X 15' X 1.5' S  
 103' X 59' FT = LEACH BED SIZE




## NOTES


- 1) DESIGNER'S SITE AT N. 50' 1798-000778
- 2) HIGH INTENSITY SURVEY BY SOPE ENVIRONMENTAL SERVICES, DREHLE, N.M. PERFORMED SUMMER 1997
- 3) DESIGN INTENT: MAINTAIN BOTTOM OF GEO-FLEX PIPES 10 FT ABOVE EXISTING GRADE OF 172.0-173.0, MAINTAINING 4 FT TO SHUT.
- 4) LARGE TREES WITHIN 10' OF THE DISPOSAL SYSTEM SHALL BE REMOVED.
- 5) DURING CONSTRUCTION, OPEN EXCAVATION SHALL BE INSTALLED FROM STORMWATER RUNOFF TO PREVENT THE ENTRANCE OF DEBRIS INTO LEACHING AREA.
- 6) ANY SHARDED OR CORRUPTED SURFACES SHALL BE RAINED TO A DEPTH OF AT LEAST 1'.
- 7) SEPTIC TANK SHALL BE CONSTRUCTED OF CONCRETE & SHALL BE WATER TIGHT.
- 8) METAL TEE BASEFLY @ JUNCT OF DISTRIBUTION BOX TO DISAPPEAR ENOUGH FOR INFLOW.
- 9) HYDRAULIC CEMENT SHALL BE USED TO SEAL AROUND SEPTIC PIPE @ FOUNDATION, WATER TIGHT & DISTRIBUTION BOX PIPING.
- 10) SEPTIC TANK SHALL BE INSPECTED FOR ACCUMULATION OF SLUDGE AT LEAST ONCE A YEAR.
- 11) IN THE EVENT A REPRESENTATIVE CONSTRUCTION MAY BE REQUIRED WITHIN 400 SF, SUTABLE LEACHING AREA.
- 12) FOUNDATION DRAINAGE ARE ALLOWED.
- 13) PROPOSED LEACHING ALLEN IS NOT WITHIN 75' OF ANY OTHER HOUSES, WELLS, OR HYDRAULIC A OR B SITES.
- 14) TEST PITS 2-23 & 2-24 WITNESSED BY M. CUDMO RECD 8-23-99
- 15) TEST PIT 1Q WITNESSED BY DICK SAND RECD 8-3-99
- 16) TEST PIT 2-Q WITNESSED BY DICK SAND RECD 10-5-99
- 17) AERIALS CONSTRUCTION MATERIAL AT CA 1999019911
- 18) SEPTIC SYSTEM CONSTRUCTED PER DESIGN.
- 19) REVISED TO SHUT AS CONSTRUCTED LOCATION AT 12/15/99
- 20) REVISED 10-10-99 - NEW HOUSE & LEACH FIELD DESIGN LOCATION
- 21) REVISED 8-3-99 - NEW HOUSE & LEACH FIELD DESIGN LOCATION

## TEST PIT DATA

TPH 2R DATE: 10/1/99  
 0-6" ORGANIC MAT  
 6-30" YELLOW BROWN FINE SANDY LOAM, GRANULAR, 10% S/L  
 30"-60" YELLOW BROWN MED. SANDY LOAM, FRABLE 10% S/L  
 SHUT=36" LEDGE=N/O WATER=N/O  
 ROOTS=36" PERC RATE=10 MIN/INCH @ 3"

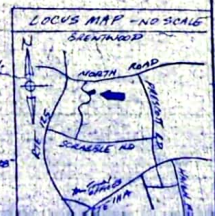


TAX MAP 3-BLOCK 1 LOT 45 "Q"  
 SUBSURFACE DISPOSAL SYSTEM  
 AS-BUILT PLAN  
 LOT "Q" BLACKTHORN SUBDIVISION  
 PHASE II  
 ON  
 LYFORD LANE  
 BRENTWOOD, N.H.  
 SCALE: 1"=20'  
 DATE: 4/10/99  
 REVISED: 8/3/99

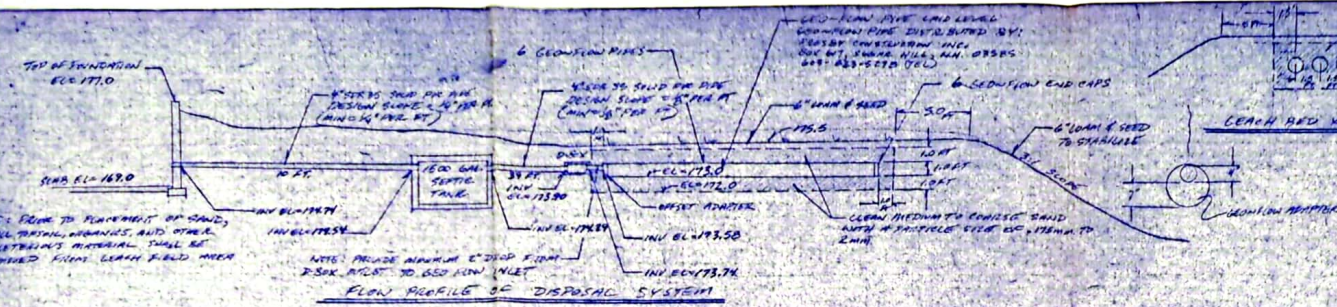

## TEST PIT DATA


TPH 1R DATE: 8/3/99  
 0-6" ORGANIC MAT  
 6-40" YELLOW BROWN FINE SANDY LOAM  
 GRANULAR, FRABLE 10% S/L  
 40"-60" YELLOW BROWN MED. SANDY LOAM  
 GRANULAR, FRABLE 10% S/L  
 SHUT=30" LEDGE=N/O ROOTS=30"  
 WATER=N/O PERC RATE=10 MIN/INCH @ 3"

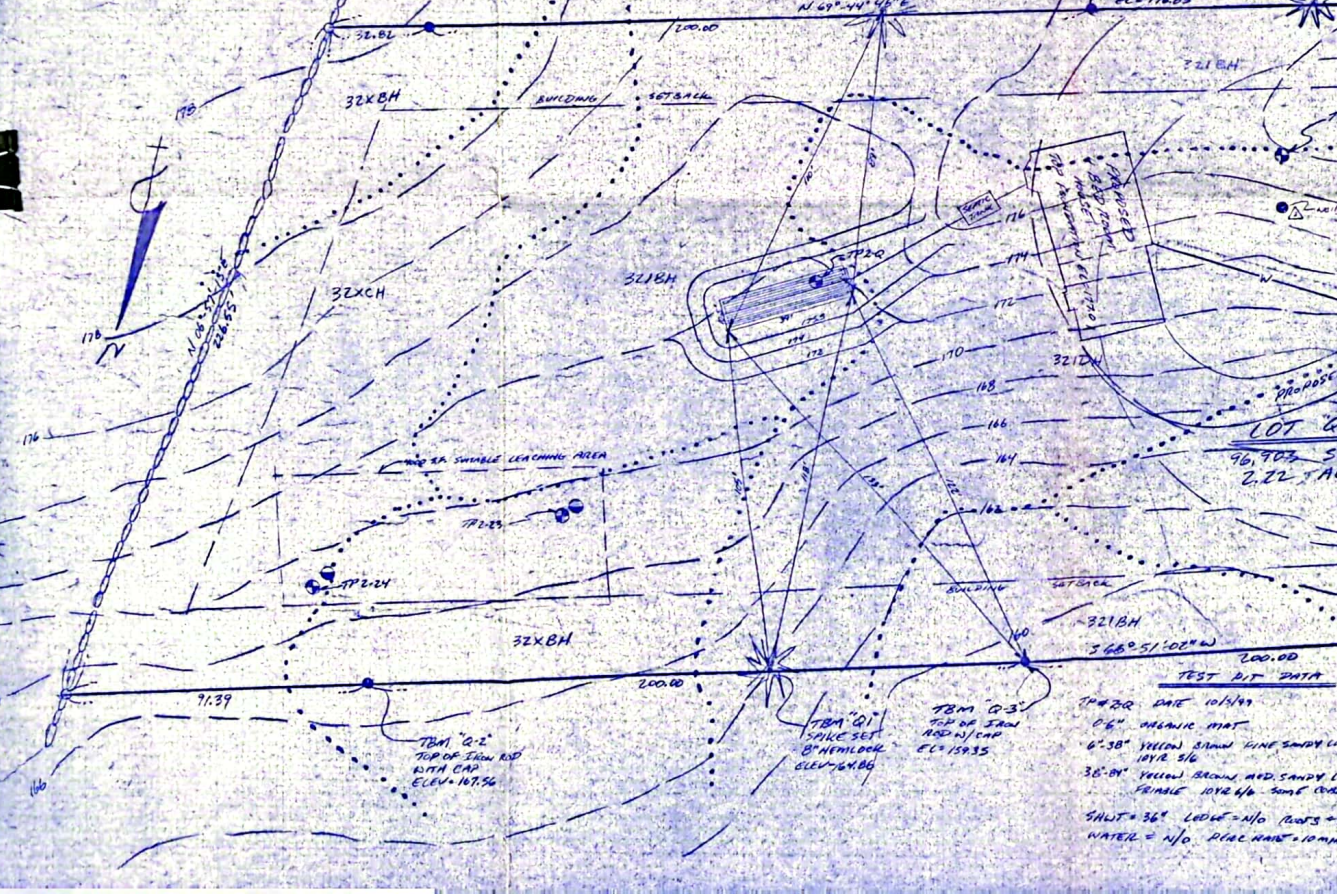








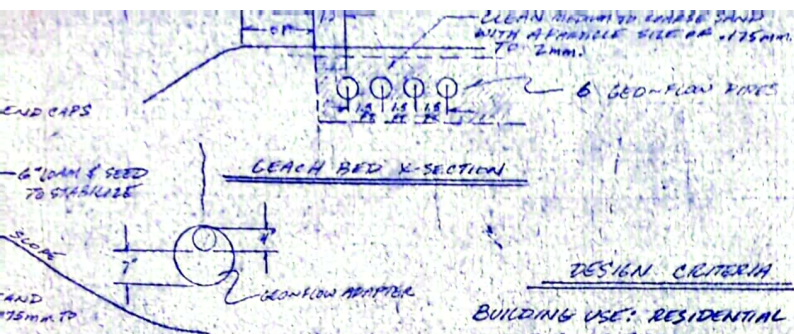

### DESIGN CRITERIA

BUILDING USE: RESIDENTIAL  
 NUMBER OF BEDROOMS: 4  
 DESIGN PERC RATE: 10 MIN/INCH  
 LEACHING AREA REQUIRED: 1100 SF  
 ALLOWED LEACHING AREA REDUCTION: 1100  
 (FOR USE OF GEONFLOW)  $\times 0.60$   
 $= 660$  SF  
 $660 \div 3 = 220$ , 220 FEET OF GEONFLOW PIPE  
 REQUIRED, PROVIDE (6) GEONFLOW PIPES 37  
 FEET LONG,  $6 \times 37 = 222$  FEET  
 $6.1 \times 5 = 30.5$ ,  $5 \times 1.5 = 7.5$   
 $7.5 + 15 + 1.5 = 24.5$   
 $10.5 \times 39$  FT = LEACH BED SIZE

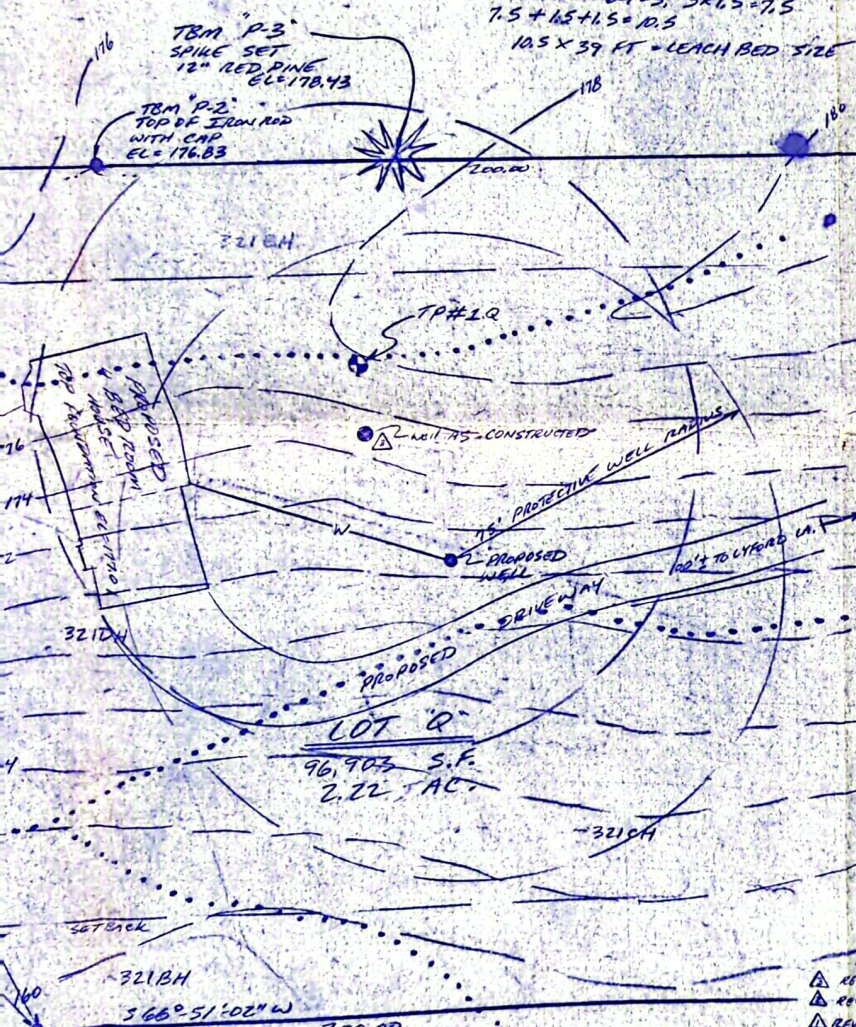


### TEST PIT DATA

TP#2R DATE 10/5/99  
 0-4" ORGANIC MAT  
 4-38" YELLOW BROWN FINE SANDY LOAM, GRAN.  
 10YR 5/6  
 38-65" YELLOW BROWN MED. SANDY LOAM  
 FRAMBLE 10YR 4/6 - SOME COBBLES  
 SHWT = 36" LEDGE = N/O ROOTS = 30"  
 WATER = N/O PERC RATE = 10 MIN/INCH @ 10"



### TEST PIT DATA

TP#2-23 DATE: 8-23-99  
 0-4" ORGANIC MAT  
 4-32" YELLOWISH BROWN SANDY LOAM  
 GRANULAR, FRAMBLE 10YR 5/6  
 32-65" OLIVE YELLOW SANDY LOAM  
 GRANULAR, FRAMBLE 2.5YR 6/8  
 SHWT = 32" LEDGE = 65" WATER = N/O  
 ROOTS = 36" PERC RATE = 10 MIN/INCH @ 30"  
 TP#2-24 DATE: 8-23-99  
 0-6" ORGANIC MAT  
 6-30" YELLOWISH BROWN SANDY LOAM  
 GRANULAR, FRAMBLE 10YR 5/6  
 30-60" OLIVE YELLOW SANDY LOAM  
 MASSIVE, FIRM 2.5YR 6/8  
 SHWT = 30" LEDGE = 60" WATER = N/O  
 ROOTS = 36" PERC RATE = 10 MIN/INCH @ 28"

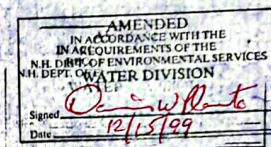

### NOTES

- 1) ALL NOTES SUBD. APP # 5A 1998-000778
- 2) HIGH INTENSITY SOIL SURVEY BY 60VE ENVIRONMENTAL SERVICES, EXETER, NH. PERFORMED SUMMER 1997
- 3) DESIGN INTENT: MAINTAIN BOTTOM OF GEONFLOW PIPE 10 FT ABOVE EXISTING GRADE OF 172.0-173.0, MAINTAINING 4 FT TO SHWT.
- 4) LARGE TREES WITHIN 10' OF THE DISPOSAL SYSTEM SHALL BE REMOVED.
- 5) DURING CONSTRUCTION, OPEN EXCAVATION SHALL BE PROTECTED FROM STORMWATER RUNOFF TO PREVENT THE ENTRANCE OF SILT & DEBRIS INTO LEACHING AREA
- 6) ANY SMOKE OR COMPRESSED GASES SHALL BE RISED TO A DEPTH OF AT LEAST 4'
- 7) SEPTIC TANK SHALL BE CONSTRUCTED OF CONCRETE & SHALL BE WATER TIGHT.
- 8) INSTALL TEE Baffle @ INLET OF DISTRIBUTION BOX TO DISSIPATE ENERGY OF INFLOW.
- 9) HYDRAULIC CEMENT SHALL BE USED TO SEAL AROUND SEPTIC PIPES @ FOUNDATION, SEPTIC TANK & DISTRIBUTION BOX JOINTS
- 10) SEPTIC TANK SHALL BE INSPECTED FOR ACCUMULATION OF SLUDGE AT LEAST ONCE A YEAR.
- 11) IN THE FUTURE A REQUIREMENT LEACHFIELD MAY BE RESULT WITHIN 4000 SF. SUITABLE LEACHING AREA
- 12) FOUNDATION DITCHES ARE ALLOWED
- 13) PROPOSED LEACHING AREA IS NOT WITHIN 75' OF ANY EXISTING HOUSES, WELLS, OR HYDROCARBON OR B SOILS
- 14) TEST PITS 2-23 & 2-24 WITNESSED BY M. CUDMO RECD 8-23-99
- 15) TEST PIT 2Q WITNESSED BY DIK BOND RECD 8-3-99
- 16) TEST PIT 2-R WITNESSED BY DIK BOND RECD 10-5-99
- 17) PREVIOUS CONSTRUCTION APPROVAL # CA 1999019911
- 18) SEPTIC SYSTEM CONSTRUCTED PER DESIGN
- 19) TO BEAT AS-CONSTRUCTED LOCATION OF WELL 11/5/99
- 20) REVISED 10-10-99 - NEW HOUSE & LEACH FIELD DESIGN LOCATION
- 21) REVISED 8-3-99 - NEW HOUSE LEACH FIELD DESIGN LOCATION



TAX MAP 3 BLOCK 1 LOT 45 "Q"  
 SUBSURFACE DISPOSAL SYSTEM  
 AS-BUILT PLAN  
 LOT "Q" BLACKTHORN SUBDIVISION  
 PHASE II  
 ON  
 LYFORD LANE  
 BRENTWOOD, N.H.  
 SCALE: 1" = 20'  
 DATE: 4/10/99  
 REVISED: 8/3/99  
 PREPARED FOR:  
 BR. GREEN BUILDERS  
 88 BARD HILL RD